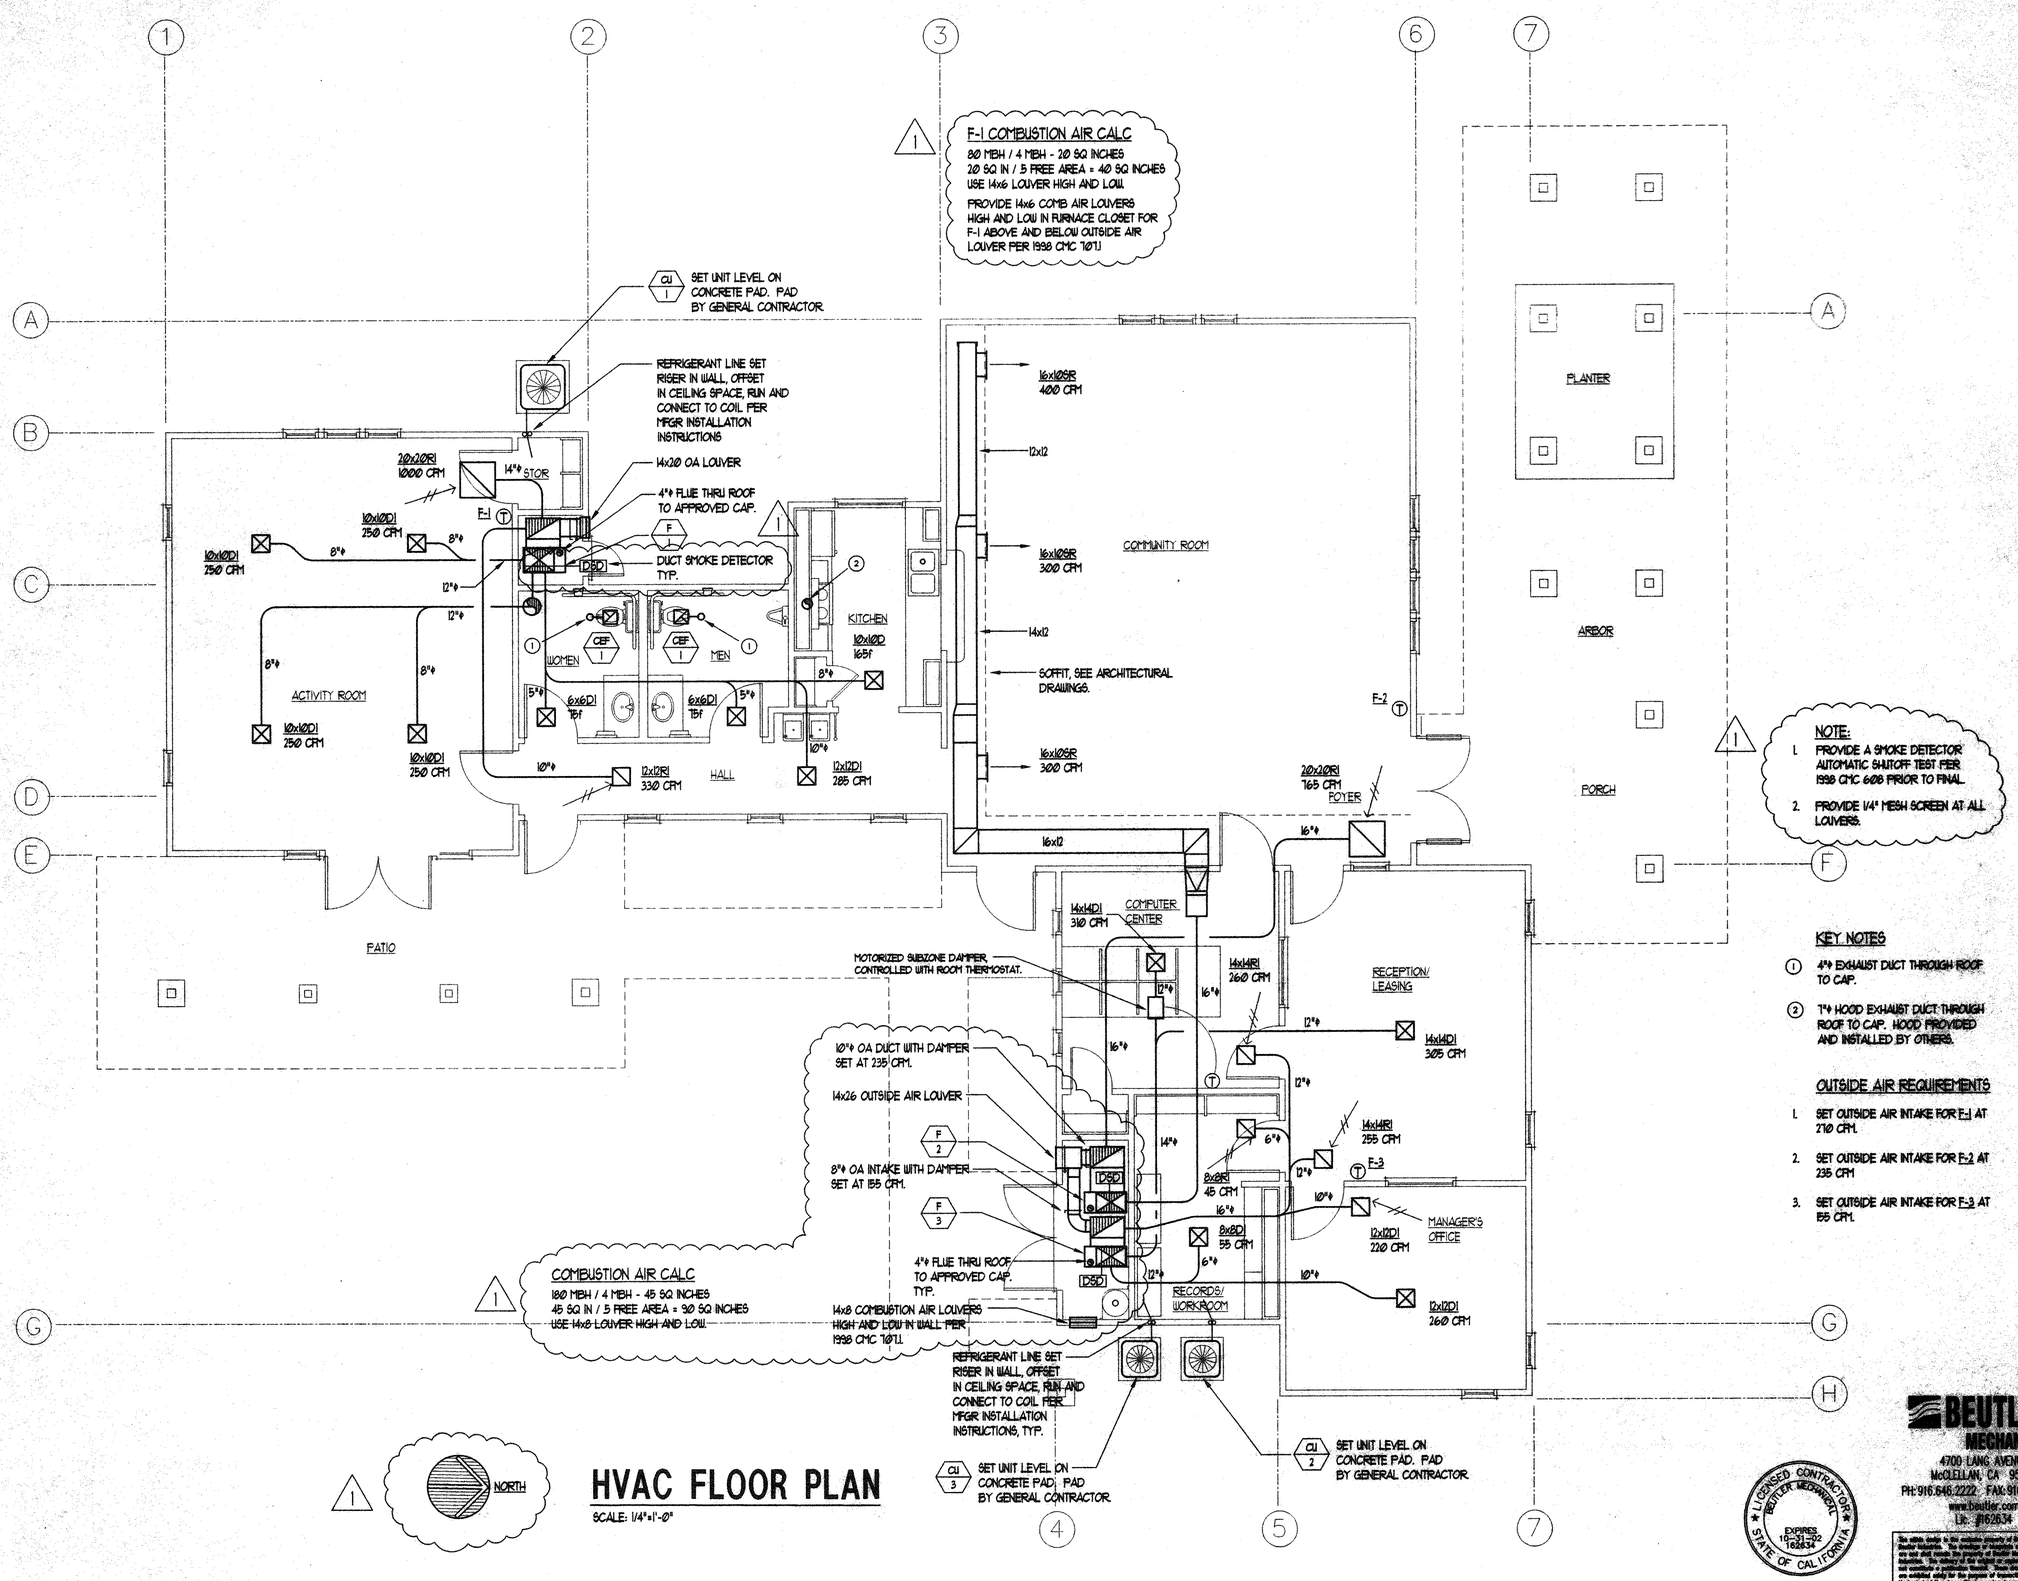

HVAC FLOOR PLAN

SCALE: 1/4"=1'-0"

KEY NOTES

1. 4"ø EXHAUST DUCT THROUGH ROOF TO CAP.
2. 7"ø HOOD EXHAUST DUCT THROUGH ROOF TO CAP. HOOD PROVIDED AND INSTALLED BY OTHERS.

OUTSIDE AIR REQUIREMENTS

1. SET OUTSIDE AIR INTAKE FOR F-1 AT 210 CFM.
2. SET OUTSIDE AIR INTAKE FOR F-2 AT 235 CFM
3. SET OUTSIDE AIR INTAKE FOR F-3 AT 155 CFM.

BEUTLER MECHANICAL
4700 LANG AVENUE
McCLELLAN, CA 95652
PH: 916.646.2222 FAX: 916.646.2263
www.beutler.com
Lic. #162634

LICENSED CONTRACTOR BEUTLER MECHANICAL EXPIRES 10-31-02 162634 STATE OF CALIFORNIA

J. H. E. VINCENT COMPANY
1500 West Shaw, Ste. 304
Fresno, California 93711
Phone: 559.225.2602
Project Consultants:
Architect:
Structural:
Civil:
Mechanical:
Electrical:
Other:

PROPOSED COMMUNITY BUILDING FOR:
WESTGATE GARDENS
EAST BELGRAVIA AVENUE & SOUTH MARTIN LUTHER KING BLVD.
FRESNO, CALIFORNIA

Issues and Revisions:

No.	Date	Issue and Reason for
1	10-1-02	PLAN CHECK 1

All drawings and written material appearing herein constitute original work of the architect and may not be duplicated, used, or disclosed without written consent of the architect.

Reference Nos.:

Scale: 1/4"=1'-0"
Project Name: WESTGATE GARDENS FRESNO, CA.
Project Number: 200218
Date: 09-09-02
Sheet Number:

M1

Of Sheets